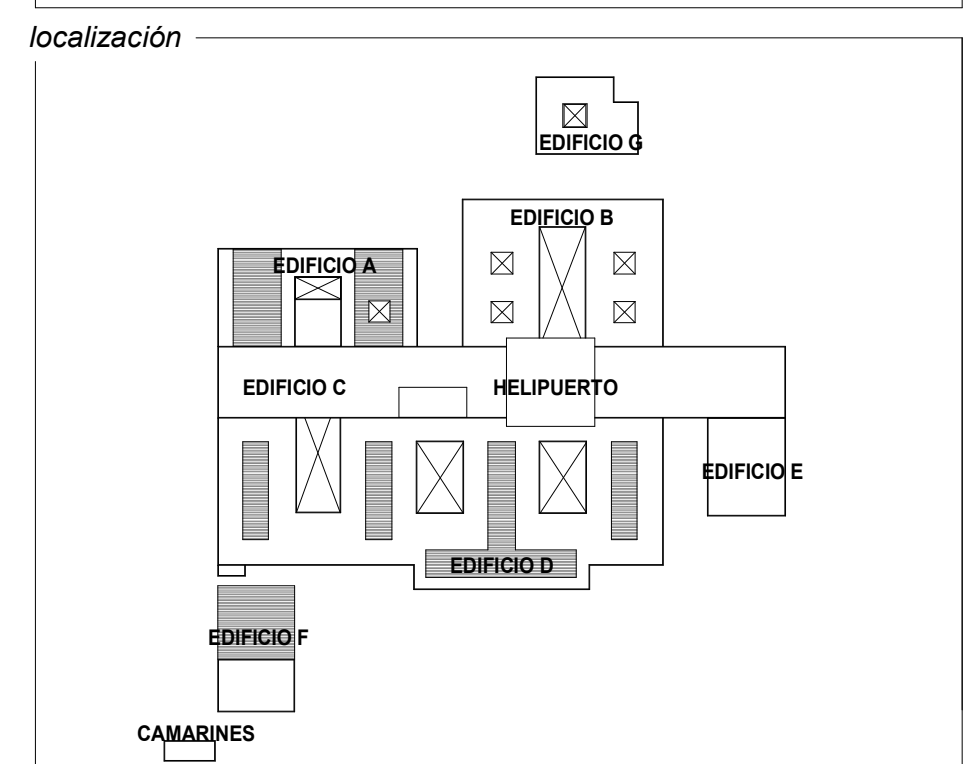


[illegible][illegible]

CONSORCIO HOSPITAL
QUILLOTA PETROSA S.A

[Handwritten signature]

MANUEL ORTIZ ESPINOZA

ARQUITECTO



arquitectos

bbats
+ tirado

ARGUMENTATION

PINE
ARQ

masfer
ARCHITECTS
DESIGN

Silvia Barbara Corral
arquitecta

SILVIA BARBERA C.
ARQUITECTO

Cristóbal Tirado Luchalángui
arquitecto

bbs + tirado

CRISTÓBAL TIRADO L.
ARQUITECTO

A photograph of a document titled "02. ARQUITECTURA". The document has several handwritten annotations in blue ink. At the top left, "Cristian" is written above "Mora". In the center, "PROYECTO" is written below "ARQUITECTURA". Below that, "CRISTIAN MORA L." is written. At the bottom, "ARQUITECTO" is written above the date "18.09.2006". There are also some illegible scribbles and a signature-like mark across the middle of the page.

IFO O ITO




Gonzalo Sepúlveda Sepúlveda
Contructor Civil
Ingeñero Fiscal
D.A. M.O.P.-REGION DE VALPARAISO
RUT: 15.252.282-7

Ingeniero Fiscal
D.A. M.O.P.-REGION DE VALPARAISO

proyecto

**PROYECTO HOSPITAL
BIPROVINCIAL QUILLOTA PETORCA**

título de plano

PLANTAS GENERALES ARQUITECTURA.
PLANTA SUBTE 1

código del plano
HBQP-PD-02ARQ-PL-12009

escala	orientación
--------	-------------

1 : 300

N

revisión	fecha	
ASBUILT	DICIEMBRE 2020	

especialidad	02ARQ Arquitectura
--------------	---------------------------